

# The District Health Department

Orange, Person, Caswell, Chatham, Lee Counties

## Water Supply and Sewage Disposal

IMPROVEMENTS PERMIT No. \_\_\_\_\_

Date 12-29-76

Owner: Fearington Development

Location: Lot # 18

Contractor: Paul Thompson

Water Supply: Private \_\_\_\_\_ Public   -  

Map  
Block  
Lot  
Fearington, PUD  
Lot # 18

Sewage Disposal Facilities: No. bedrooms \_\_\_\_\_ Dishwasher, Disposal, washing machine, other automatic appliances \_\_\_\_\_  
Size of tank: 1/100 Nitrification line: 480x3

Other disposal facility: \_\_\_\_\_

Water supply and sewage disposal facilities location, installation and protection must meet state and local regulations.

Septic tank should be pumped out every 3 to 5 years and shall be maintained by owner in such a manner as not to create a public health hazard. Septic tank and nitrification line **MUST BE INSPECTED AND APPROVED BY A MEMBER OF THE DISTRICT HEALTH DEPARTMENT STAFF BEFORE ANY PORTION OF THE INSTALLATION IS COVERED AND PUT INTO USE.**

Date approved: \_\_\_\_\_  
Well: \_\_\_\_\_  
Sewage Disposal: \_\_\_\_\_  
By: \_\_\_\_\_

Signed J.D. Collins  
Sanitarian  
Counter signed \_\_\_\_\_  
(Owner or his representative)

### Certificate of Completion


Date Approved: 12-29-76 By: J.D. Collins  
Sanitarian

(OVER)

Location of well and sewage disposal facilities sketched on back.

NOTE: Make sketch of installation showing lot size and shape, location of house, septic tanks, privies, water supplies, etc. Note special problems existing on lot. Write in measurements in order that installations may be located at later date. Note location of water supplies on adjacent lots.

(1)

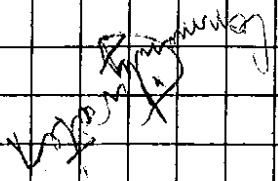

(2)

